
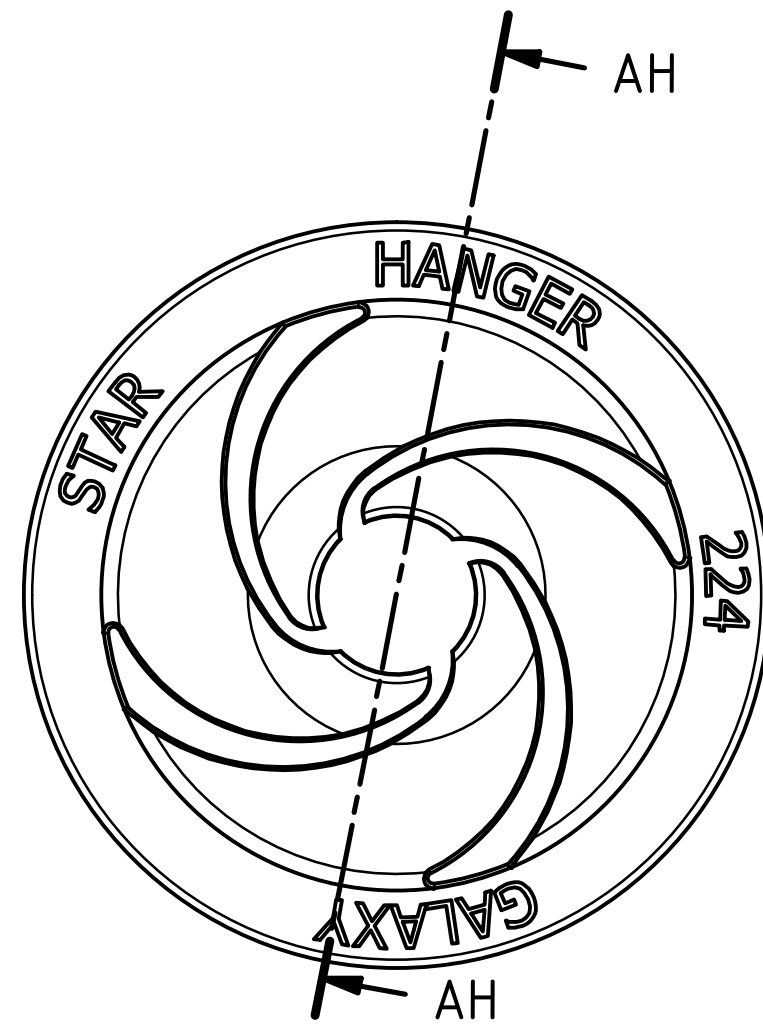



AH-AH (3 : 1)

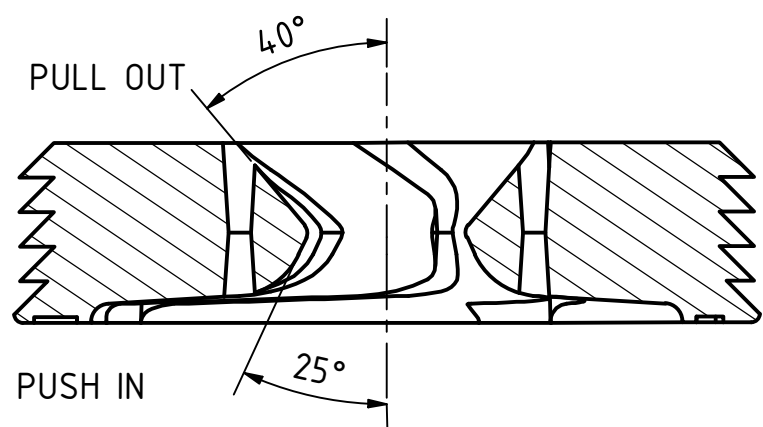

Project name : 224 Galaxy		Designed by :
File name : 224 Galaxy 4 arms		
Customer : Charles Porter		 <p>Star Hanger systems</p> <p>PRACTICAL PANEL HANGING INNOVATIONS</p>
Material :		
Size :		
Thickness :		
Created : 13.09.2021		
Altered :	Units : mm	