
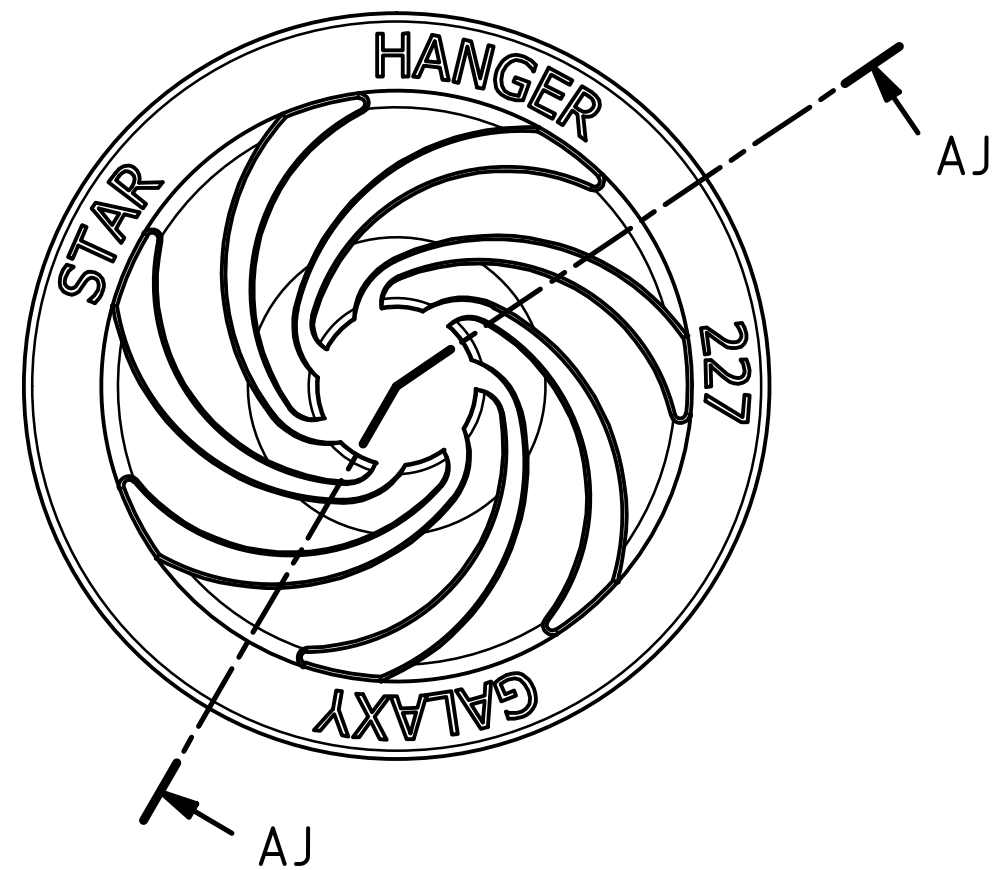



AJ-AJ (3 : 1)

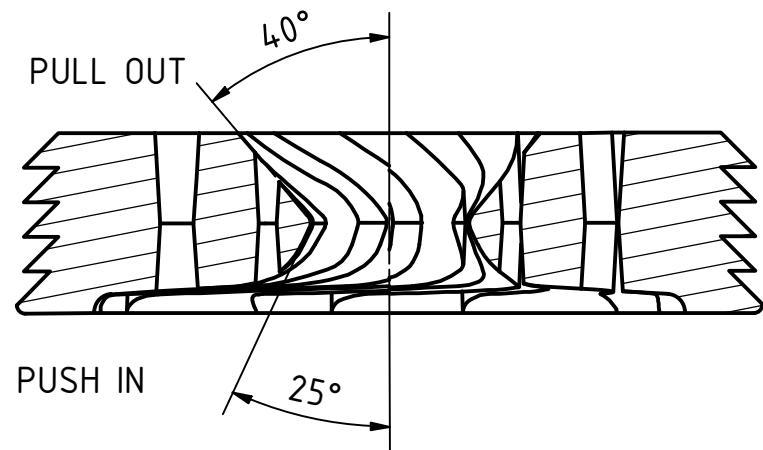

Project name :227 Galaxy		Designed by :
File name : 227 Galaxy 7 arms		 <p>Star Hanger systems</p> <p>PRACTICAL PANEL HANGING INNOVATIONS</p>
Customer : Charles Porter		
Material :		
Size :		
Thickness :		
Created : 13.09.2021		
Altered :	Units : mm	